

STATE ENGINEER
Salem, Oregon

LINN
4685

Well Record

STATE WELL NO. 10/3W-11N(1)
COUNTY Linn
APPLICATION NO. GR-537

OWNER: Clara C. Kizer


MAILING ADDRESS: 1805 Kenworthy Road

LOCATION OF WELL: Owner's No. 1

CITY AND STATE: Albany, Oregon

SW 1/4 SW 1/4 Sec. 11 T. 10 N. S. R. 3 W., W.M.

Bearing and distance from section or subdivision
corner N. 76° 13' W. 2450 chs. from SE cor. SW 1/4
Sec. 11

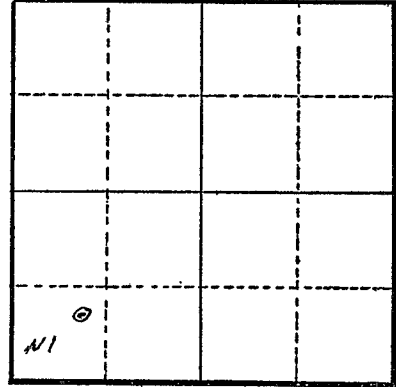

Section 11

Altitude at well 215 ft.

TYPE OF WELL: drilled Date Constructed 6/17/55

Depth drilled 22 ft. Depth cased 22 ft.

CASING RECORD: 8 inch

FINISH:

AQUIFERS:

WATER LEVEL: 10 ft.

PUMPING EQUIPMENT: Type centrifugal H.P. 15
Capacity 250 G.P.M.

WELL TESTS:
Drawdown 10 ft. after 250 hours G.P.M.
Drawdown ft. after hours G.P.M.

USE OF WATER irrigation 25.5 acres Temp. °F. 19

SOURCE OF INFORMATION GR-539

DRILLER or DIGGER Bill Hamilton Drilling Co.; Albany, Oregon

ADDITIONAL DATA:

Log Water Level Measurements Chemical Analysis Aquifer Test

REMARKS: