

STATE ENGINEER  
Salem, Oregon

LINN  
4687

# Well Record

STATE WELL NO. 10/3W-11P(1)  
COUNTY Linn  
APPLICATION NO. GR-299

OWNER: Rose M. Grenz


MAILING ADDRESS: Rt. 2, Box 428A

LOCATION OF WELL: Owner's No. 1

CITY AND STATE: Albany, Oregon

SE 1/4 SW 1/4 Sec. 11 T. 10 N. S. R. 3 W., W.M.

Bearing and distance from section or subdivision corner N. 9° 07' W. 11.46 chs. from SW cor. SE 1/4 Sec. 11

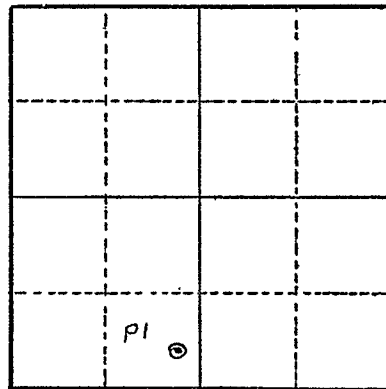

Section 11

Altitude at well 215 ft. Interpolated

TYPE OF WELL: drilled Date Constructed 6/10/42

Depth drilled 23 ft. Depth cased 23 ft.

CASING RECORD: 4 inch steel casing set from 0 to 23 ft.

FINISH: silt perforations set from 15 to 23 ft.

AQUIFERS: unknown

WATER LEVEL: 10 ft. below land surface

PUMPING EQUIPMENT: Type Gardner - Denver type B 2" centrifugal H.P. 15  
Capacity 320 G.P.M.

WELL TESTS:  
Drawdown 6 ft. after \_\_\_\_\_ hours pumping 350 G.P.M.  
Drawdown \_\_\_\_\_ ft. after \_\_\_\_\_ hours \_\_\_\_\_ G.P.M.

USE OF WATER irrigation 19.6 acres Temp. \_\_\_\_\_ °F. \_\_\_\_\_, 19

SOURCE OF INFORMATION Reg. St. GR-299

DRILLER or DIGGER Wymore Well Drillers; Rt. 2, Box 317, Salem, Oregon

ADDITIONAL DATA:

Log \_\_\_\_\_ Water Level Measurements \_\_\_\_\_ Chemical Analysis \_\_\_\_\_ Aquifer Test \_\_\_\_\_

REMARKS: