

STATE ENGINEER
Salem, Oregon

LINN
4808

Well Record

GR- 1400

STATE WELL NO. 10/3W-16B
COUNTY Linn
APPLICATION NO. GR- 1453

OWNER: L. Charles & Alice Henion


MAILING ADDRESS: Rt. 2, Box 359

LOCATION OF WELL: Owner's No. #4

CITY AND STATE: Albany, Oregon

NW 1/4 NE 1/4 Sec. 16 T. 10 S., R. 3 W., W.M.

Bearing and distance from section or subdivision corner S.60°E. 11 ch. from NW cor. DIC #60

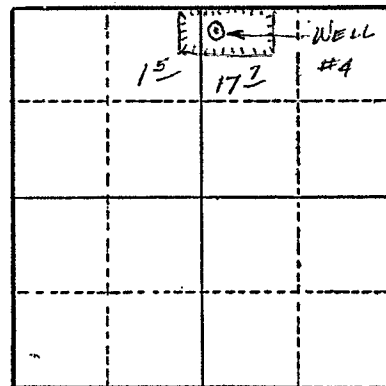

Section 16

Altitude at well 210'

TYPE OF WELL: Drilled Date Constructed 1951

Depth drilled 28' Depth cased 28'

CASING RECORD:
10"

FINISH:

Slot perforated from 22' to 28'

AQUIFERS:

WATER LEVEL:

12'

PUMPING EQUIPMENT: Type F.M. 2" Cent. H.P. 10
Capacity 250 G.P.M.

WELL TESTS:

Drawdown 6 ft. after hours 250 G.P.M.

Drawdown ft. after hours G.P.M.

USE OF WATER Irrigation Temp. °F. , 19

SOURCE OF INFORMATION GR Record

DRILLER or DIGGER

ADDITIONAL DATA:

Log N.A. Water Level Measurements Chemical Analysis Aquifer Test

REMARKS:

Irrigation of 19.2 acres.