

STATE ENGINEER
Salem, Oregon

LINA
4809

Well Record

GR- 1168

STATE WELL NO. 10/3W-16B
COUNTY Linn
APPLICATION NO. GR- 1208

OWNER: H. Kenneth Severance


MAILING ADDRESS: Rt. 2, Box 402C

LOCATION OF WELL: Owner's No. _____

CITY AND STATE: Albany, Oregon

XX XX
NW 1/4 NE 1/4 Sec. 16 T. 10 S., R. 3 W., W.M.

Bearing and distance from section or subdivision
corner S. 28°15'E. 1150.4' from NW cor. DLC # 60.
or 1150'S. & 375'E. from N 1/4 cor. Sec. 16.

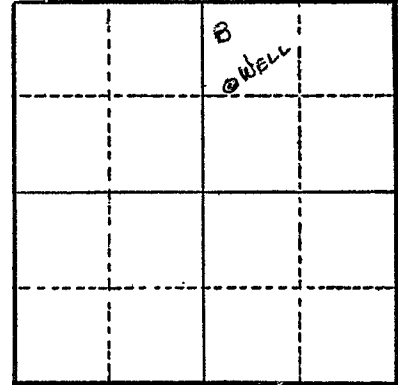

Section 16

Altitude at well 210 ft.

TYPE OF WELL: Drilled Date Constructed 1954

Depth drilled 36 ft. Depth cased 35 ft.

CASING RECORD:

6 in. from 0 to 35 ft.

FINISH:

Slot perforations from 29 to 35 ft.

AQUIFERS:

WATER LEVEL:

12 ft.

PUMPING EQUIPMENT: Type 1 in. Cent. H.P. 3

Capacity 75 G.P.M.

WELL TESTS:

Drawdown 10 ft. after _____ hours 200 G.P.M.

Drawdown _____ ft. after _____ hours _____ G.P.M.

USE OF WATER Irrigation Temp. _____ °F., 19 _____

SOURCE OF INFORMATION G. R. Record

DRILLER or DIGGER Nicholas Klaus

ADDITIONAL DATA:

Log N.A. Water Level Measurements _____ Chemical Analysis _____ Aquifer Test _____

REMARKS:

Irrigation of 6 acres.