

STATE ENGINEER
Salem, Oregon

LINN
4816

Well Record

GR- 1652

STATE WELL NO. 10/3W-160
COUNTY Linn
APPLICATION NO. GR- 1703

OWNER: J. H. Lyon


MAILING ADDRESS: Rt. 2, Box 408

LOCATION OF WELL: Owner's No.

CITY AND STATE: Albany, Oregon

SW 1/4 SE 1/4 Sec. 16 T. 10 S., R. 3 W., W.M.

Bearing and distance from section or subdivision corner 660' N. & 3820' E. from SW cor. Sec. 16

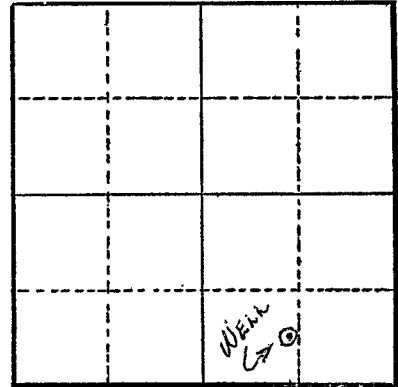

Section 16

Altitude at well 220'

TYPE OF WELL: Drilled Date Constructed 1951

Depth drilled 30' Depth cased 30'

CASING RECORD:

6"

FINISH:

Slot perforations from 20 to 30 ft.

AQUIFERS:

WATER LEVEL:

10'

PUMPING EQUIPMENT: Type Sears jet H.P. 3

Capacity 30 G.P.M.

WELL TESTS:

Drawdown ft. after hours G.P.M.

Drawdown ft. after hours G.P.M.

USE OF WATER Irrigation Temp. °F., 19

SOURCE OF INFORMATION GR Record

DRILLER or DIGGER Bill Hamilton

ADDITIONAL DATA:

Log N.A. Water Level Measurements Chemical Analysis Aquifer Test

REMARKS:

Irrigation of 3.5 acres.