

STATE ENGINEER
Salem, Oregon

LINN
4863

Well Record

STATE WELL NO. 10/3W-18B(1)
COUNTY Linn
APPLICATION NO. GR-1036

GR- 1001

OWNER: C.L. & Ida Mae Parker


MAILING ADDRESS: Rt. 2, Box 291

LOCATION OF WELL: Owner's No. #1

CITY AND STATE: Albany, Oregon

NW 1/4 NE 1/4 Sec. 18 T. 10 S., R. 3 W., W.M.

Bearing and distance from section or subdivision corner S49°50'E. 12.5 ch. N1/4 cor. Sec. 18.

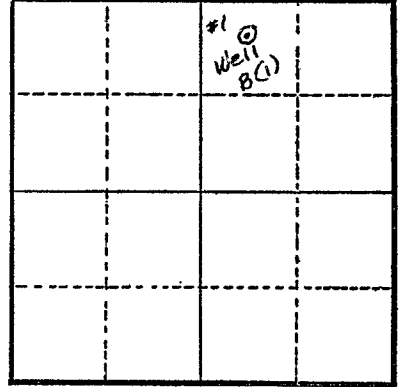

Section 18

Altitude at well 190 ft.

TYPE OF WELL: Drilled Date Constructed 1953

Depth drilled 42 ft. Depth cased 42 ft.

CASING RECORD:

10 inch

FINISH:

Slot perforations from 32 to 42 ft.

AQUIFERS:

WATER LEVEL:

14 ft.

PUMPING EQUIPMENT: Type 2" Cent. H.P. 10

Capacity 250 G.P.M.

WELL TESTS:

Drawdown 6 ft. after 200 hours G.P.M.

Drawdown ft. after hours G.P.M.

USE OF WATER Irrigation Temp. °F. 19

SOURCE OF INFORMATION G.R. Record

DRILLER or DIGGER Nicholas Klaus

ADDITIONAL DATA:

Log N.A. Water Level Measurements Chemical Analysis Aquifer Test

REMARKS:

Irrigation of 37.1 acres.