

STATE ENGINEER
Salem, Oregon

LINN
4866

Well Record

STATE WELL NO. 10/3W-18E
COUNTY Linn
APPLICATION NO. GR-3000

OWNER: P.L. Turnidge

MAILING ADDRESS:

Route 2, Box 310

LOCATION OF WELL: Owner's No. #4


CITY AND STATE:

Albany, Oregon

SW 1/4 NW 1/4 Sec. 18 T. 10 N S, R. 3 W., W.M.

Bearing and distance from section or subdivision

corner N. 77° E. 41 chains

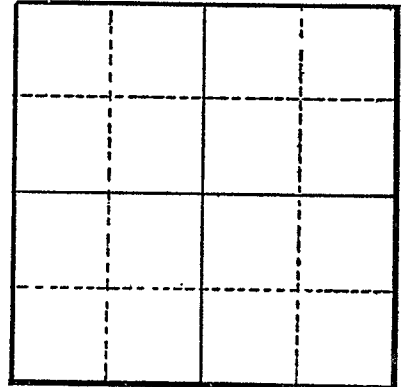

Section

Altitude at well

TYPE OF WELL: drilled Date Constructed 1951

Depth drilled 30 Depth cased 30

CASING RECORD:

10-inch

FINISH:

slot perforations from 20 to 30

AQUIFERS:

Soil, sand and gravel

WATER LEVEL:

16-feet

PUMPING EQUIPMENT: Type Pacific Centrifugal
Capacity 500 G.P.M.

H.P. 20

WELL TESTS:

Drawdown 1 ft. after hours pumping 600 G.P.M.

Drawdown ft. after hours G.P.M.

USE OF WATER Irrigation

Temp. °F., 19

SOURCE OF INFORMATION GR-2809

DRILLER or DIGGER Bill Hamilton Drilling Co., Albany, Oregon

ADDITIONAL DATA:

Log Water Level Measurements Chemical Analysis Aquifer Test

REMARKS:

Soil	10	10
Sand and gravel	20	30