

STATE ENGINEER
Salem, Oregon

LINN
4871

Well Record


STATE WELL NO. 10/3W-18K
COUNTY LINN
APPLICATION NO. GR-2283

OWNER: Thomas and Carole G. Wilkinson MAILING ADDRESS: Rt. 2, Box 292 C., Albany

LOCATION OF WELL: Owner's No. CITY AND STATE: Albany, Oregon

NW 1/4 SE 1/4 Sec. 18 T. 10 S., R. 3 W., W.M.

Bearing and distance from section or subdivision corner S. 85° 40' W. 26.25 chains from SW corner of D10 69.

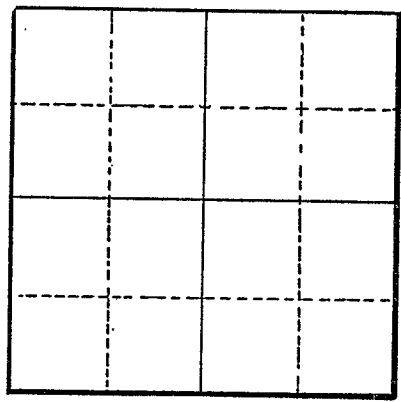

Section

Altitude at well

TYPE OF WELL: Drilled Date Constructed 1955

Depth drilled 37 Depth cased 37

CASING RECORD:

8-inch

FINISH:

Perforations from 27 to 37

AQUIFERS:

WATER LEVEL:

23-feet

PUMPING EQUIPMENT: Type Berkeley 2" centrifugal H.P. 15
Capacity 250 G.P.M.

WELL TESTS:

Drawdown 2 ft. after hours Pumping 250 G.P.M.
Drawdown ft. after hours G.P.M.

USE OF WATER Irrigation Temp. °F., 19

SOURCE OF INFORMATION GR-2176

DRILLER or DIGGER Slate Drilling Co., Tangent, Oregon

ADDITIONAL DATA:

Log Water Level Measurements Chemical Analysis Aquifer Test

REMARKS: