

STATE ENGINEER
Salem, Oregon

LINN
4872

Well Record

GR- 1680

STATE WELL NO. 10/3W-18K
COUNTY Linn
APPLICATION NO. GR- 1732

OWNER: Ed Messman

MAILING

ADDRESS: Rt. 2, Box 296

LOCATION OF WELL: Owner's No. #1


CITY AND

STATE: Albany, Oregon

NW 1/4 SE 1/4 Sec. 18 T. 10 S., R. 3 W., W.M.

Bearing and distance from section or subdivision

corner N. 5°30'E. 29.5 ch. from SW cor. of SE 1/4 of
Section 18.

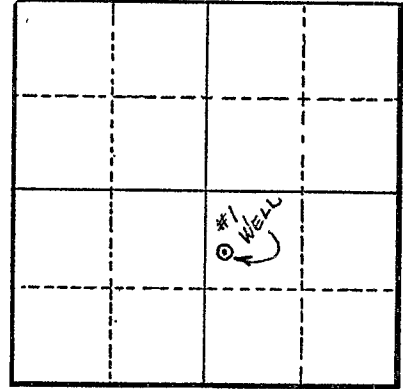

Section 18

Altitude at well 195'

TYPE OF WELL: Drilled Date Constructed 1954

Depth drilled 34' Depth cased 34'

CASING RECORD:

10"

FINISH:

Slot perforations from 30 to 34 ft.

AQUIFERS:

WATER LEVEL:

17'

PUMPING EQUIPMENT: Type Pacific 3" Cent.

H.P. 15

Capacity 350 G.P.M.

WELL TESTS:

Drawdown 4 ft. after June 1950 hours 300 G.P.M.

Drawdown ft. after hours G.P.M.

USE OF WATER Irrigation Temp. °F. 19

SOURCE OF INFORMATION GR Record

DRILLER or DIGGER Nicholas Klaus

ADDITIONAL DATA:

Log N.A. Water Level Measurements Chemical Analysis Aquifer Test

REMARKS:

Irrigation of 14.1 acres.