

STATE ENGINEER
Salem, Oregon

LINN
4877

Well Record


STATE WELL NO. 10/3W-18M(1)
COUNTY Linn
APPLICATION NO. GR-327

OWNER: Marvin W. & Helen E. Fletcher MAILING ADDRESS: Rt. 2, Box 315

LOCATION OF WELL: Owner's No. 2 CITY AND STATE: Albany, Oregon

NW 1/4 SW 1/4 Sec. 18 T. 10 N. S., R. 3 E. W., W.M.

Bearing and distance from section or subdivision corner S. 7.5 chs. from NE cor. SE 1/4 Sec. 13

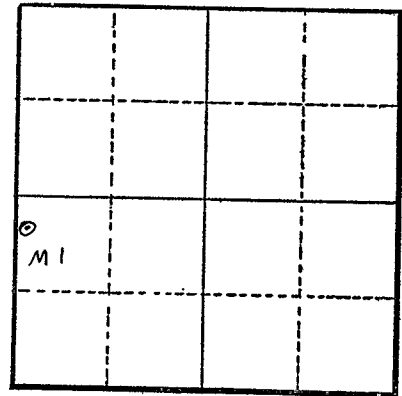

Section 18

Altitude at well 180 ft. Interpolated

TYPE OF WELL: drilled Date Constructed 6/25/54

Depth drilled 35 ft. Depth cased 35 ft.

CASING RECORD: 8 inch steel casing set from 0 to 35 ft.

FINISH: slit perforations from 20 to 35 ft.

AQUIFERS: unknown

WATER LEVEL: 10 ft. below land surface

PUMPING EQUIPMENT: Type Fairbanks Morse 2" centrifugal H.P. 10
Capacity 200 G.P.M.

WELL TESTS:
Drawdown ft. after hours G.P.M.
Drawdown ft. after hours G.P.M.

USE OF WATER irrigation 17.6 acres Temp. °F. 19

SOURCE OF INFORMATION Reg. St. GR-327

DRILLER or DIGGER Nicholas Klaus; Albany, Oregon

ADDITIONAL DATA:
Log Water Level Measurements Chemical Analysis Aquifer Test

REMARKS: