

STATE ENGINEER
Salem, Oregon

LINN
4878

Well Record

STATE WELL NO. 10/3W-18Q(1)
COUNTY Linn
APPLICATION NO. GR-143

OWNER: George W. & Elsie Schwab
MAILING ADDRESS: Rt. 2, Box 293


LOCATION OF WELL: Owner's No. 1
CITY AND STATE: Albany, Oregon

SW 1/4 SE 1/4 Sec. 18 T. 10 N. S. R. 3 W., W.M.

Bearing and distance from section or subdivision

corner 18.6 chs. W. from SE cor. Edmond C. McClain

DLC 70

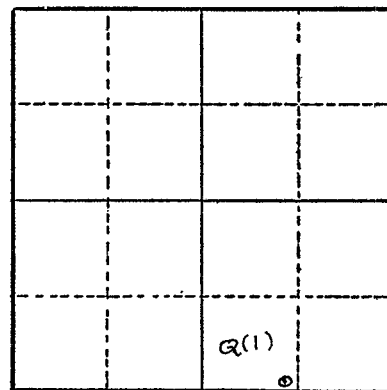

Altitude at well 197 ft. Interpolated

TYPE OF WELL: drilled Date Constructed 10/3/54

Depth drilled 35 ft. Depth cased 35 ft.

Section 18

CASING RECORD: 8 inch casing set from 0 to 35 ft.

FINISH: slit perforations from 25 to 35 ft.

AQUIFERS: unknown

WATER LEVEL: 6 ft. below land surface Oct. 5, 1954

PUMPING EQUIPMENT: Type Fairbanks Morse centrifugal 2" H.P. 10
Capacity 250 G.P.M.

WELL TESTS:
Drawdown 18 ft. after 600 hours G.P.M.
Drawdown ft. after hours G.P.M.

USE OF WATER Irrigation 40 acres Temp. °F. 19

SOURCE OF INFORMATION Reg. St. GR-143

DRILLER or DIGGER Nicholas Klaus; Rt. 4, Albany, Oregon

ADDITIONAL DATA:

Log Water Level Measurements Chemical Analysis Aquifer Test

REMARKS:



Oregon Water Resources Department
725 Summer Street NE, Suite A
Salem Oregon 97301
(503) 986-0900
www.oregon.gov/owrd

Application for Well ID Number

Do not complete if the well already has a Well Identification Number.

RECEIVED

OCT 29 2024

I. OWNER INFORMATION

OWRD

Current Owner Name (please print): Martin and Melisa Miller Trust

Mailing Address: 32450 Millersburg Dr NE

City, State, Zip: Albany, OR 97321

Mail Well ID to: ☐ SAME AS ABOVE ☒ In Care Of (C/O)

Name & Address: Udell Engineering and Land Surveying c/o Kyle Latimer 63 E Ash St

City, State, Zip: Lebanon, OR 97355

II. WELL LOCATION INFORMATION (Please fill out as completely as possible)

Township: 10 South (North / South) Range: 3 West (East / West) Section: 18 SW 1/4 of the SE 1/4

Tax Lot (usually last 3-5 numbers of Tax Map #): 902 (map10s03w18) County Linn

GPS Coordinates: 44.69388° North 123.09736° West

Street Address of Well, City: 32450 Millersburg Dr NE

If the property had a different street address in the past: unknown

III. GENERAL WELL INFORMATION (Please fill out as completely as possible, AND attach copy of Well Report, if available)

Use of Well (domestic, irrigation, commercial, industrial, monitoring): irrigation

Date Well Constructed (or property built): 10/3/1954 Total Well Depth: 35' Casing Diameter: 8"

Owner at time the well was constructed (if known): George and Elsie Schwab Well Report # (if known): Linn 4878

Other Information: _____

SUBMITTED BY (please print): Kyle Latimer

PHONE: 541-451-5125

EMAIL &/or FAX: kyle@udelleng.com

To send the completed application, you may MAIL it to: Oregon Water Resources Dept. 725 Summer St NE, Suite A, Salem, Oregon 97301.
Or EMAIL the completed PDF form to: Ladeena.K.Ashley@water.oregon.gov, or FAX it to: (503) 986-0902.

For Official Use Only by the Oregon Water Resources Department:

Received Date:

10-29-2024

Well Report Number:

LINN 4878

Well Identification #:

L-156038