

STATE ENGINEER  
Salem, Oregon

LINN  
4878

# Well Record

STATE WELL NO. 10/3W-18Q(1)  
COUNTY Linn  
APPLICATION NO. GR-143

OWNER: George W. & Elsie Schwab


MAILING ADDRESS: Rt. 2, Box 293

LOCATION OF WELL: Owner's No. 1

CITY AND STATE: Albany, Oregon

SW 1/4 SE 1/4 Sec. 18 T. 10 N. S., R. 3 E. W., W.M.

Bearing and distance from section or subdivision corner 18.6 chs. W. from SE cor. Edmond C. McClain  
DLC 70

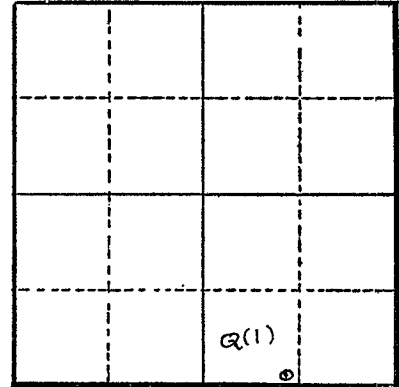

Section 18

Altitude at well 197 ft. Interpolated

TYPE OF WELL: drilled Date Constructed 10/3/54

Depth drilled 35 ft. Depth cased 35 ft.

CASING RECORD: 8 inch casing set from 0 to 35 ft.

FINISH: slit perforations from 25 to 35 ft.

AQUIFERS: unknown

WATER LEVEL: 6 ft. below land surface Oct. 5, 1954

PUMPING EQUIPMENT: Type Fairbanks Morse centrifugal 2" H.P. 10  
Capacity 250 G.P.M.

WELL TESTS:  
Drawdown 18 ft. after \_\_\_\_\_ hours 600 G.P.M.  
Drawdown \_\_\_\_\_ ft. after \_\_\_\_\_ hours \_\_\_\_\_ G.P.M.

USE OF WATER Irrigation 40 acres Temp. \_\_\_\_\_ °F. \_\_\_\_\_, 19

SOURCE OF INFORMATION Reg. St. GR-143

DRILLER or DIGGER Nicholas Klaus; Rt. 4, Albany, Oregon

ADDITIONAL DATA:

Log \_\_\_\_\_ Water Level Measurements \_\_\_\_\_ Chemical Analysis \_\_\_\_\_ Aquifer Test \_\_\_\_\_

REMARKS: