

STATE ENGINEER
Salem, Oregon

LINN
4910

Well Record


STATE WELL NO. 10/3W - 20B
COUNTY LINN
APPLICATION NO. GR-2024

OWNER: Herbert S. and Helen L. Wood
MAILING ADDRESS: Rt. 2, Box 287

LOCATION OF WELL: Owner's No.
CITY AND STATE: Albany, Oregon

NW 1/4 NE 1/4 Sec. 20 T. 10 N. S., R. 3 W., W.M.

Bearing and distance from section or subdivision corner 858' S. and 2046' W.

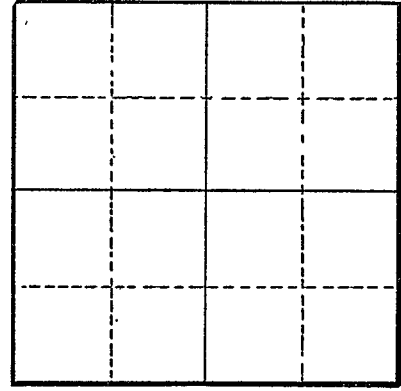

Section

Altitude at well

TYPE OF WELL: Drilled Date Constructed 1950

Depth drilled 132 Depth cased 30

CASING RECORD:

10-inch

FINISH:

Perforation from 0 to 30

AQUIFERS:

WATER LEVEL:

90-feet

PUMPING EQUIPMENT: Type Peerless Deep Well Turbine H.P. 5
Capacity 150 G.P.M.

WELL TESTS:

Drawdown 100 ft. after hours Pumping 80 G.P.M.
Drawdown ft. after hours G.P.M.

USE OF WATER Irrigation Temp. °F., 19

SOURCE OF INFORMATION GR-1950

DRILLER or DIGGER Cy. Burkhart

ADDITIONAL DATA:

Log Water Level Measurements Chemical Analysis Aquifer Test

REMARKS: