

STATE ENGINEER
Salem, Oregon

LINN
5058

Well Record

STATE WELL NO. 10/3W-24H
COUNTY Linn
APPLICATION NO. GR-3736

OWNER: Harvey Mitchell


MAILING ADDRESS: Route 1

LOCATION OF WELL: Owner's No. 2

CITY AND STATE: Jefferson, Oregon

SE 1/4 NE 1/4 Sec. 24 T. 10 N. S., R. 3 E. W., W.M.

Bearing and distance from section or subdivision corner 990 feet North 40° West of E1/4 Corner, Section 24.

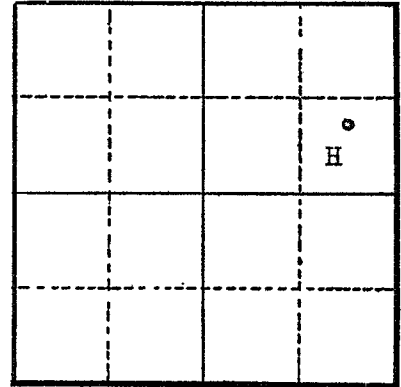

Section 24

Altitude at well 226 feet

TYPE OF WELL: Drilled Date Constructed 1952

Depth drilled 25 feet Depth cased

CASING RECORD:

10 inch

FINISH:

AQUIFERS:

WATER LEVEL:

10 feet

PUMPING EQUIPMENT: Type Fairbanks Morse H.P.
Capacity G.P.M.

WELL TESTS:

Drawdown 8 ft. after hours 600 G.P.M.

Drawdown ft. after hours G.P.M.

USE OF WATER Irrigation Temp. °F., 19

SOURCE OF INFORMATION GR-4144

DRILLER or DIGGER Bill Hamilton, Albany

ADDITIONAL DATA:

Log (NA) Water Level Measurements Chemical Analysis Aquifer Test

REMARKS: