

STATE ENGINEER  
Salem, Oregon

LENN  
5060

# Well Record

STATE WELL NO. 10/3W-24K  
COUNTY Linn  
APPLICATION NO. GR-3737

OWNER: Harvey Mitchell

MAILING ADDRESS:

Route 1

LOCATION OF WELL: Owner's No. 3

CITY AND STATE:


Jefferson, Oregon

NW 1/4 SE 1/4 Sec. 24 T. 10 S., R. 3 W., W.M.

Bearing and distance from section or subdivision

corner 2505 feet West and 557 feet South of

E 1/4 Corner, Section 24.

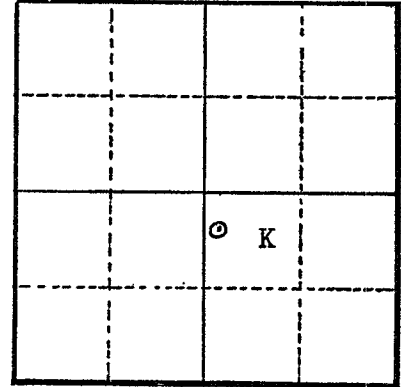

Section 24

Altitude at well 226 feet

TYPE OF WELL: Drilled Date Constructed 1953

Depth drilled 25 feet Depth cased \_\_\_\_\_

CASING RECORD:

10 inch

FINISH:

8' screens 3/8" wide to 12" long from 6 to \_\_\_\_\_

AQUIFERS:

WATER LEVEL:

8 feet

PUMPING EQUIPMENT: Type Fairbanks Morse H.P. \_\_\_\_\_  
Capacity 600 G.P.M.

WELL TESTS:

Drawdown 11 ft. after \_\_\_\_\_ hours 600 G.P.M.

Drawdown \_\_\_\_\_ ft. after \_\_\_\_\_ hours \_\_\_\_\_ G.P.M.

USE OF WATER Irrigation Temp. \_\_\_\_\_ °F., 19 \_\_\_\_\_

SOURCE OF INFORMATION GR-4145

DRILLER or DIGGER Bill Hamilton, Albany

ADDITIONAL DATA:

Log (NA) Water Level Measurements \_\_\_\_\_ Chemical Analysis \_\_\_\_\_ Aquifer Test \_\_\_\_\_

REMARKS: