

STATE ENGINEER  
Salem, Oregon

LINN  
5061

# Well Record

STATE WELL NO. 10/3W-24R  
COUNTY Linn  
APPLICATION NO. GR-3739

OWNER: Harvey Mitchell


MAILING ADDRESS: Route 1

LOCATION OF WELL: Owner's No. 5

CITY AND STATE: Jefferson, Oregon

SE 1/4 SE 1/4 Sec. 24 T. 10 S., R. 3 W., W.M.

Bearing and distance from section or subdivision corner 1071 feet North 70° West of SE Corner, Section 24.

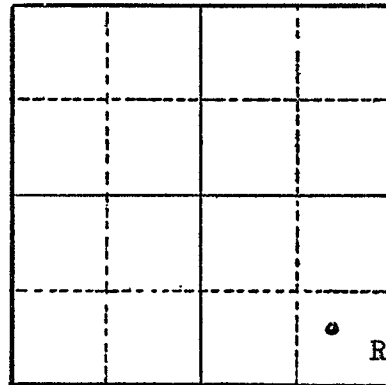

Section 24

Altitude at well 226 feet

TYPE OF WELL: Drilled Date Constructed 1948

Depth drilled 25 feet Depth cased

### CASING RECORD:

10-inch steel casing

### FINISH:

### AQUIFERS:

### WATER LEVEL:

5' 7"

PUMPING EQUIPMENT: Type Fairbanks Morse H.P.  
Capacity G.P.M.

### WELL TESTS:

Drawdown 6 ft. after 800 hours G.P.M.

Drawdown ft. after hours G.P.M.

USE OF WATER Irrigation Temp. °F., 19

SOURCE OF INFORMATION GR-4146

DRILLER or DIGGER Bill Hamilton, Albany

### ADDITIONAL DATA:

Log (NA) Water Level Measurements Chemical Analysis Aquifer Test

### REMARKS: