

STATE ENGINEER
Salem, Oregon

LINN
5068

Well Record

STATE WELL NO. 10/3W-25C(1)
COUNTY Linn
APPLICATION NO. GR-697

OWNER: Ivan C. & Edith M. Pinkston

MAILING

ADDRESS: Rt. 2, Box 452


LOCATION OF WELL: Owner's No. 1

CITY AND

STATE: Albany, Oregon

NE $\frac{1}{4}$ NW $\frac{1}{4}$ Sec. 25 T. 10 N. S., R. 3 E. W., W.M.

Bearing and distance from section or subdivision
corner N. 28° 15' E. 17 chs. from SE cor. DIC 50

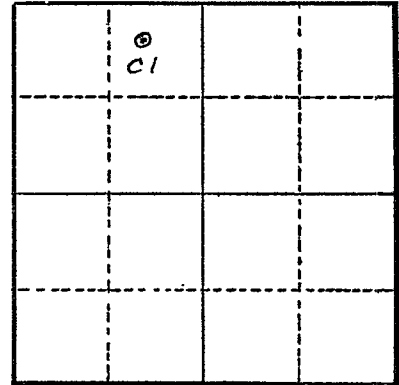

Section 25

Altitude at well 225 ft. Interpolated

TYPE OF WELL: drilled Date Constructed June 1952

Depth drilled 30 ft. Depth cased 30 ft.

CASING RECORD: 10 inch

FINISH:

AQUIFERS:

WATER LEVEL: 12 ft.

PUMPING EQUIPMENT: Type Berkeley centrifugal H.P. 15
Capacity 350 G.P.M.

WELL TESTS:

Drawdown 4 ft. after 600 hours 600 G.P.M.

Drawdown ft. after hours G.P.M.

USE OF WATER irrigation 61.8 acres Temp. °F., 19

SOURCE OF INFORMATION GR-697

DRILLER or DIGGER Bill Hamilton; Albany, Oregon

ADDITIONAL DATA:

Log Water Level Measurements Chemical Analysis Aquifer Test

REMARKS: