

STATE ENGINEER  
Salem, Oregon

Linn  
51755 Well Record

STATE WELL NO. 10/2W-11M(1)  
COUNTY Linn  
APPLICATION NO. GR-608

Don Hale New owner

OWNER: ~~Donald W. & May E. Warden~~

MAILING ADDRESS: Rt. 2, Box 399


LOCATION OF WELL: Owner's No. 1

CITY AND STATE: Scio, Oregon

NW 1/4 SW 1/4 Sec. 11 T. 10 S, R. 2 E, W.M.

Bearing and distance from section or subdivision

corner S. 31 1/2° E. 15.5 chs. from NW cor. SW 1/4 Sec. 11

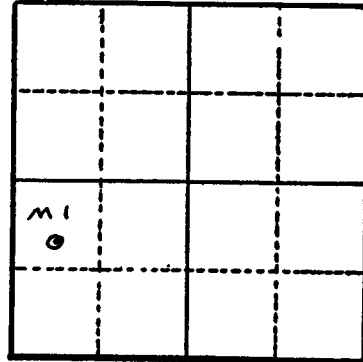

Section 11

Altitude at well 305 ft.

TYPE OF WELL: drilled Date Constructed May, 1952

Depth drilled 72 ft. Depth cased 72 ft.

CASING RECORD: 10 inch

FINISH:

AQUIFERS:

WATER LEVEL: 12 ft.

PUMPING EQUIPMENT: Type Fairbanks Morse deep well H.P. 10  
Capacity 250 G.P.M.

WELL TESTS:

Drawdown 3 ft. after 500 hours G.P.M.

Drawdown ft. after hours G.P.M.

USE OF WATER irrigation 27 acres Temp. °F. 19

SOURCE OF INFORMATION GR-608

DRILLER or DIGGER Carl Sanders; Lebanon, Oregon

ADDITIONAL DATA:

Log Water Level Measurements Chemical Analysis Aquifer Test

REMARKS: