

STATE ENGINEER
Salem, Oregon

Linn
5228

Well Record

STATE WELL NO. 10/3W-33L(1)
COUNTY Linn
APPLICATION NO. GR-402

OWNER: Geo. & Harriet Settemier


MAILING ADDRESS: 1650 N. Pacific Hwy.

LOCATION OF WELL: Owner's No.

CITY AND STATE: Albany, Oregon

NE 1/4 SW 1/4 Sec. 33 T. 10 N. S. R. 3 E. W.M.

Bearing and distance from section or subdivision corner S. 1° 56' E. 900 ft. from NW cor. DLC 43 thence S. 89° 50' W. 1185 ft. to pump

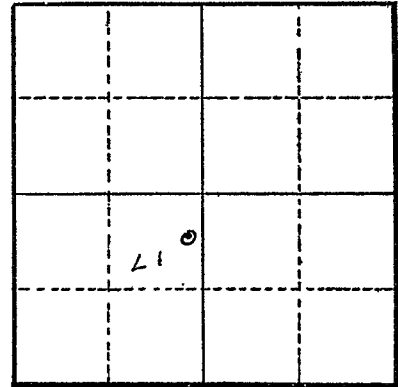

Section 33

Altitude at well 195 ft.

TYPE OF WELL: sump Date Constructed 1948

Depth drilled Depth cased

CASING RECORD:

FINISH:

AQUIFERS:

WATER LEVEL:

PUMPING EQUIPMENT: Type H.P. Capacity G.P.M.

WELL TESTS:
Drawdown ft. after hours G.P.M.
Drawdown ft. after hours G.P.M.

USE OF WATER irrigation 5 acres Temp. °F., 19

SOURCE OF INFORMATION GR-402

DRILLER or DIGGER

ADDITIONAL DATA:

Log Water Level Measurements Chemical Analysis Aquifer Test

REMARKS: Sump: 125 ft. x 300 ft. 10 to 15 ft. deep