

STATE ENGINEER
Salem, Oregon

Linn
5241

Well Record


STATE WELL NO. 10/3W-34G(1)
COUNTY Linn
APPLICATION NO. GR-159

OWNER: Harvey E. Brenneman
MAILING ADDRESS: Rt. 2, Box 519

LOCATION OF WELL: Owner's No. _____
CITY AND STATE: Albany, Oregon

SW 1/4 NE 1/4 Sec. 34 T. 10 S., R. 3 W., W.M.

Bearing and distance from section or subdivision
corner N. 36° 10' W. 7.01 chs. from NE cor.
Milton Houston DIC 43

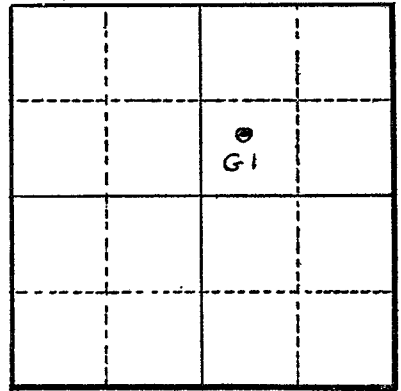

Section 34

Altitude at well _____

TYPE OF WELL: drilled Date Constructed 11/35 1/56

Depth drilled 126 ft. Depth cased 97 1/4 ft.

CASING RECORD: 8 inch, set from 0 to 97 1/4 ft.

FINISH: Perforations from 25 to 26, 35 to 36, 45 to 46, 53 to 55, 62 to 64, and 70 to 71 ft.

AQUIFERS: Sand and gravel

WATER LEVEL: 4 ft. below land surface

PUMPING EQUIPMENT: Type turbine H.P. 10
Capacity _____ G.P.M.

WELL TESTS:
Drawdown 95 ft. after 5 hours pumping 200 G.P.M.
Drawdown _____ ft. after _____ hours _____ G.P.M.

USE OF WATER irrigation Temp. 49 °F. winter 1955 - 1956, 19

SOURCE OF INFORMATION Well Drillers Report

DRILLER or DIGGER Wm. M. Slate

ADDITIONAL DATA:
Log Water Level Measurements _____ Chemical Analysis _____ Aquifer Test _____

REMARKS:

