

STATE ENGINEER
Salem, Oregon

Linn
5297

Well Record

GR- 1528

STATE WELL NO. 10/4W-1H
COUNTY Linn
APPLICATION NO. GR- 4256

OWNER: N. L. Grate


MAILING ADDRESS: Rt. 2, Box 356

LOCATION OF WELL: Owner's No. #3

CITY AND STATE: Albany, Oregon

SE 1/4 NE 1/4 Sec. 1 T. 10 S, R. 4 W, W.M.

Bearing and distance from section or subdivision corner N. 35° 25' W. 12.5 ch. from E¹ cor. Sec. 1

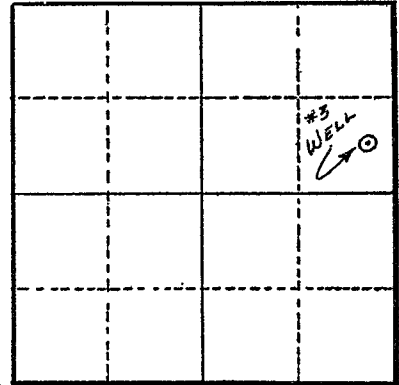

Section 1

Altitude at well 175'

TYPE OF WELL: Drilled Date Constructed 1944

Depth drilled 20' Depth cased 20'

CASING RECORD:
10"

FINISH:
Slot perforations from 17 to 20 ft.

AQUIFERS:

WATER LEVEL:
13'

PUMPING EQUIPMENT: Type F. M. 8" Cent. H.P. 15
Capacity 400 G.P.M.

WELL TESTS:
Drawdown ft. after hours G.P.M.
Drawdown ft. after hours G.P.M.

USE OF WATER Irrigation Temp. °F., 19

SOURCE OF INFORMATION GR Record
DRILLER or DIGGER Bill Hamilton Drilling Co.

ADDITIONAL DATA:
Log N.A. Water Level Measurements Chemical Analysis Aquifer Test

REMARKS:
Irrigation of 44.5 acres.