

STATE ENGINEER
Salem, Oregon

Linn
5298

Well Record

STATE WELL NO. 10/44-1J(1)
COUNTY Linn
APPLICATION NO. GR-970

GR-941

OWNER: Rebecca Hofer

MAILING ADDRESS: Rt. 2, Box 333


LOCATION OF WELL: Owner's No.

CITY AND STATE: Albany, Oregon

NE 1/4 SE 1/4 Sec. 1 T. 10 S, R. 4 W, W.M.

Bearing and distance from section or subdivision

corner S50°W 14.78 ch. from the NE cor. of SE 1/4 of sec. 1.

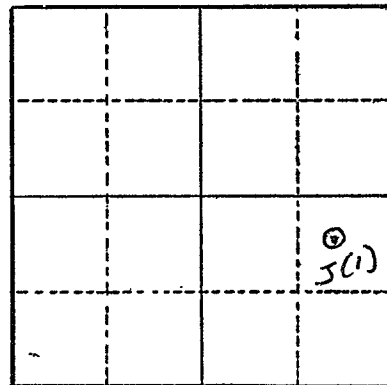

Section 1

Altitude at well 175 ft.

TYPE OF WELL: Drilled Date Constructed 1944

Depth drilled 20 ft. Depth cased 20 ft.

CASING RECORD:

10 inch

FINISH:

Slot perforations from 14 to 20 ft.

AQUIFERS:

WATER LEVEL:

5 ft.

PUMPING EQUIPMENT: Type American Marsh 3" Centrifugal H.P. 20
Capacity 400 G.P.M.

WELL TESTS:

Drawdown 1 ft. after 1000 hours G.P.M.

Drawdown ft. after hours G.P.M.

USE OF WATER Irrigation Temp. °F. 19

SOURCE OF INFORMATION G.R. Record

DRILLER or DIGGER Bill Hamilton Drilling Co.

ADDITIONAL DATA:

Log Water Level Measurements Chemical Analysis Aquifer Test

REMARKS:

Irrigation of 47.7 acres.