

STATE ENGINEER
Salem, Oregon

Linn
5302

Well Record


STATE WELL NO. 10/LW-2J(1)
COUNTY Linn
APPLICATION NO. GR-712

OWNER: Robert P. Richardson
MAILING ADDRESS: Rt. 2, Box 385

LOCATION OF WELL: Owner's No. 1
CITY AND STATE: Albany, Oregon

NE 1/4 SE 1/4 Sec. 2 T. 10 N. S. R. 4 E. W., W.M.

Bearing and distance from section or subdivision
corner 2000 ft. N. & 550 ft. W. from SE cor. Sec. 2

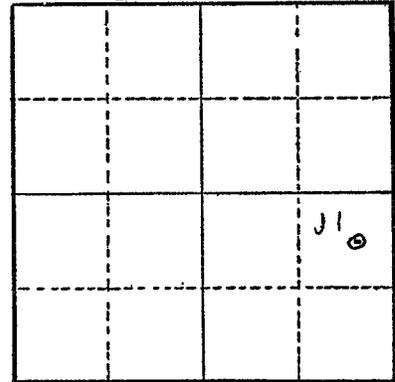

Section 2

Altitude at well 170 ft. Interpolated

TYPE OF WELL: drilled Date Constructed Feb. 1947

Depth drilled 30 ft. Depth cased 30 ft.

CASING RECORD: 10 in. casing from 0 to 30 ft.

FINISH:

AQUIFERS:

WATER LEVEL: 10 ft.

PUMPING EQUIPMENT: Type Pacific centrifugal H.P. 15
Capacity 450 G.P.M.

WELL TESTS:
Drawdown 2 ft. after 800 hours G.P.M.
Drawdown ft. after hours G.P.M.

USE OF WATER irrigation Temp. °F. 19

SOURCE OF INFORMATION GR-712

DRILLER or DIGGER

ADDITIONAL DATA:

Log Water Level Measurements Chemical Analysis Aquifer Test

REMARKS:

