

STATE ENGINEER
Salem, Oregon

Linn
5303

Well Record

STATE WELL NO. 10/LW-2K
COUNTY LINN
APPLICATION NO. GR-2297


OWNER: Clifford G. and Laverne G. Chambers MAILING ADDRESS: Rt. 2, Box 321

LOCATION OF WELL: Owner's No. #2 CITY AND STATE: Albany, Oregon

NW 1/4 SE 1/4 Sec. 2 T. 10 S., R. 4 W., W.M.

Bearing and distance from section or subdivision corner N. 46° 55' W. 36.5 chains from SE corner

S. 2. T. 10 S., R. 4 W.

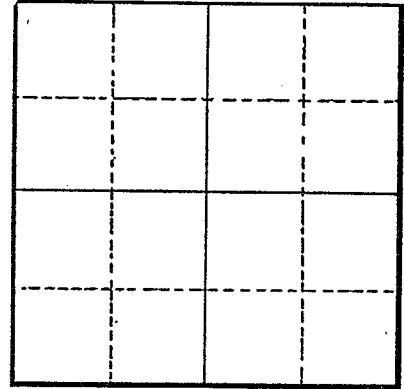

Section

Altitude at well

TYPE OF WELL: Drilled Date Constructed 1951

Depth drilled 30 Depth cased 30

CASING RECORD:

8-inch

FINISH:

Slot perforations from 20 to 30

AQUIFERS:

WATER LEVEL:

6-feet

PUMPING EQUIPMENT: Type Cornell 3" Centrifugal H.P. 80
Capacity 1000 G.P.M.

WELL TESTS:

Drawdown ft. after hours G.P.M.

Drawdown ft. after hours G.P.M.

USE OF WATER Irrigation Temp. °F., 19

SOURCE OF INFORMATION GR-2192

DRILLER or DIGGER Bill Hamilton Drilling Co., 838 East Third Ave., Albany, Oregon

ADDITIONAL DATA:

Log Water Level Measurements Chemical Analysis Aquifer Test

REMARKS: