

STATE ENGINEER
Salem, Oregon

Linn
5315

Well Record


STATE WELL NO. 10/4W-11B
COUNTY LINN
APPLICATION NO. GR-2535

OWNER: Parry Roth
MAILING ADDRESS: Rt. 2, Box 328

LOCATION OF WELL: Owner's No. #2
CITY AND STATE: Albany, Oregon

NW 1/4 NE 1/4 Sec. 11 T. 10 S., R. 4 W., W.M.

Bearing and distance from section or subdivision
corner 1221' S. & 130' W.

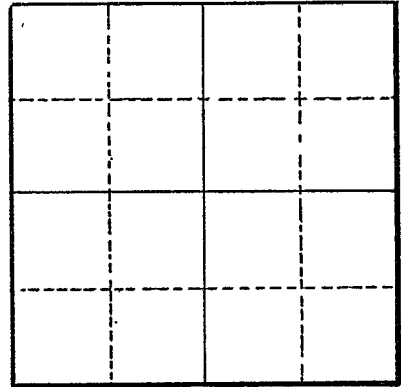

Section

Altitude at well

TYPE OF WELL: Drilled Date Constructed 1953

Depth drilled 32 Depth cased 31

CASING RECORD:

10-inch

FINISH:

AQUIFERS:

WATER LEVEL:

10-feet

PUMPING EQUIPMENT: Type Fairbanks Morse Centrifugal H.P. 25
Capacity 400 G.P.M.

WELL TESTS:

Drawdown ft. after hours G.P.M.
Drawdown ft. after hours G.P.M.

USE OF WATER Irrigation Temp. °F. 19

SOURCE OF INFORMATION GR-2395

DRILLER or DIGGER Nicholas Klaus, Rt. 4, Albany, Oregon

ADDITIONAL DATA:

Log Water Level Measurements Chemical Analysis Aquifer Test

REMARKS: