

STATE ENGINEER  
Salem, Oregon

Linn  
5316

# Well Record

STATE WELL NO. 10/LW-11B(1)  
COUNTY Linn  
APPLICATION NO. GR-475


OWNER: Charles & Patricia Chambers

MAILING ADDRESS: Rt. 2, Box 329

LOCATION OF WELL: Owner's No. 1

CITY AND STATE:

NW 1/4 NE 1/4 Sec. 11 T. 10 N. S. R. 4 W., W.M.

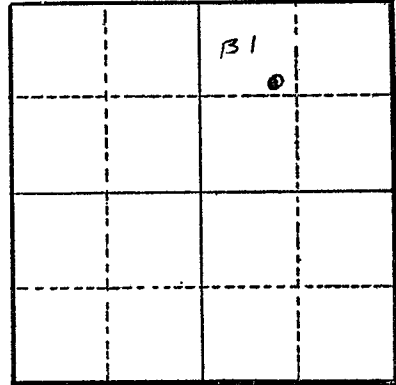

Bearing and distance from section or subdivision corner S. 44° 20' E. 25.7 chs. from NW cor. NE 1/4 Sec. 11

Section 11

Altitude at well 175 ft.

TYPE OF WELL: drilled Date Constructed 4/5/51

Depth drilled 34 ft. Depth cased 34 ft.

CASING RECORD: 8 inch

FINISH:

AQUIFERS:

WATER LEVEL: 13 ft.

PUMPING EQUIPMENT: Type Pacific centrifugal H.P. 20  
Capacity 500 G.P.M.

WELL TESTS:  
Drawdown 2.5 ft. after \_\_\_\_\_ hours 700 G.P.M.  
Drawdown \_\_\_\_\_ ft. after \_\_\_\_\_ hours \_\_\_\_\_ G.P.M.

USE OF WATER irrigation 35.5 ac. Temp. \_\_\_\_\_ °F. \_\_\_\_\_, 19.

SOURCE OF INFORMATION GR-475

DRILLER or DIGGER Nicholas Klaus; Rt. 4, Albany, Oregon

ADDITIONAL DATA:  
Log \_\_\_\_\_ Water Level Measurements \_\_\_\_\_ Chemical Analysis \_\_\_\_\_ Aquifer Test \_\_\_\_\_

REMARKS: