

STATE ENGINEER
Salem, Oregon

Linn
5317

Well Record


STATE WELL NO. 10/4W-11F
COUNTY LINN
APPLICATION NO. GR-2534

OWNER: Perry Roth
MAILING ADDRESS: Rt. 2, Box 328

LOCATION OF WELL: Owner's No. #1
CITY AND STATE: Albany, Oregon

SE 1/4 NW 1/4 Sec. 11 T. 10 S., R. 4 W., W.M.

Bearing and distance from section or subdivision
corner 1485' S. and 462' W.

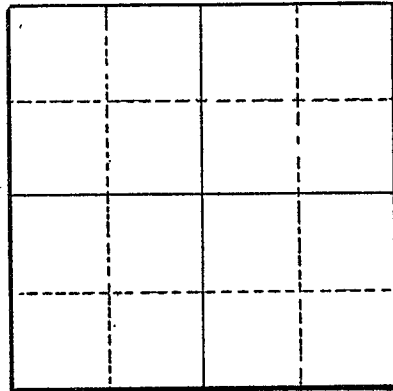

Section

Altitude at well

TYPE OF WELL: Drilled Date Constructed 1945

Depth drilled 30 Depth cased 30

CASING RECORD:

10-inch

FINISH:

Slot perforations from 25 to 29

AQUIFERS:

WATER LEVEL:

8 feet

PUMPING EQUIPMENT: Type Pacific Centrifugal H.P. 15
Capacity 350 G.P.M.

WELL TESTS:

Drawdown ft. after hours G.P.M.
Drawdown ft. after hours G.P.M.

USE OF WATER Irrigation Temp. °F., 19

SOURCE OF INFORMATION GR-2394

DRILLER or DIGGER Mr. Studebaker, Salem, Oregon

ADDITIONAL DATA:

Log Water Level Measurements Chemical Analysis Aquifer Test

REMARKS: