

STATE ENGINEER
Salem, Oregon

Linn
5318


Well Record

STATE WELL NO. 10/LW-11H(1)
COUNTY Linn
APPLICATION NO. GR-645

OWNER: Aden A. Chambers
MAILING ADDRESS: Rt. 2, Box 322

LOCATION OF WELL: Owner's No. 1
CITY AND STATE: Albany, Oregon

SE 1/4 NE 1/4 Sec. 11 T. 10 S., R. 4 W., W.M.
Bearing and distance from section or subdivision
corner S. 67 1/2° W. 26.75 chs. from most northerly
NW cor. DLC 38

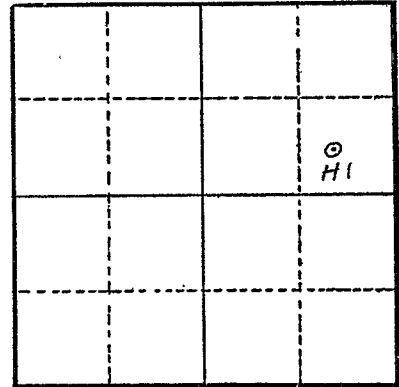

Section 11

Altitude at well 172 ft. Interpolated

TYPE OF WELL: drilled Date Constructed May 1944

Depth drilled 26 ft. Depth cased 26 ft.

CASING RECORD: 12 inch casing

FINISH:

AQUIFERS:

WATER LEVEL: 12 ft.

PUMPING EQUIPMENT: Type Fairbanks Morse centrifugal H.P. 15
Capacity 400 G.P.M.

WELL TESTS:
Drawdown 5 ft. after hours 400 G.P.M.
Drawdown ft. after hours G.P.M.

USE OF WATER irrigation 27.5 acres Temp. °F. 19

SOURCE OF INFORMATION GR-645

DRILLER or DIGGER W. O. Boyer, Salem, Oregon

ADDITIONAL DATA:
Log Water Level Measurements Chemical Analysis Aquifer Test

REMARKS: One of 4 wells