

STATE ENGINEER  
Salem, Oregon

Linn  
5319

# Well Record


STATE WELL NO. 10/4W-11J(1)  
COUNTY Linn  
APPLICATION NO. GR-646

OWNER: Aden A. Chambers  
MAILING ADDRESS: Rt. 2, Box 322

LOCATION OF WELL: Owner's No. 2  
CITY AND STATE: Albany, Oregon

NE 1/4 SE 1/4 Sec. 11 T. 10 N. S., R. 4 W., W.M.

Bearing and distance from section or subdivision  
corner S. 45 3/4° W. 37.5 chs. from most northerly  
NW cor. DLG 38

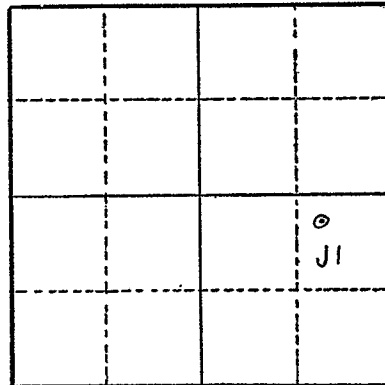

Section 11

Altitude at well 273 ft. Interpolated

TYPE OF WELL: drilled Date Constructed 1941

Depth drilled 19 1/2 ft. Depth cased 19 1/2 ft.

CASING RECORD: 12 inch

FINISH:

AQUIFERS:

WATER LEVEL: 7 ft.

PUMPING EQUIPMENT: Type Cornell centrifugal H.P. 30  
Capacity 700 G.P.M.

WELL TESTS:  
Drawdown 3 ft. after 1000 hours G.P.M.  
Drawdown ft. after hours G.P.M.

USE OF WATER irrigation 66.5 acres Temp. °F. 19

SOURCE OF INFORMATION GR-646

DRILLER or DIGGER Fred Wymore; Salem, Oregon

ADDITIONAL DATA:  
Log Water Level Measurements Chemical Analysis Aquifer Test

REMARKS: