

STATE ENGINEER
Salem, Oregon

Linn
5320

Well Record

STATE WELL NO. 10/LW-119(1)
COUNTY Linn
APPLICATION NO. GR-649

OWNER: Aden A. Chambers


MAILING ADDRESS: Rt. 2, Box 322

LOCATION OF WELL: Owner's No. 4

CITY AND STATE: Albany, Oregon

SW 1/4 SE 1/4 Sec. 11 T. 10 N. S., R. 4 E. W., W.M.

Bearing and distance from section or subdivision
corner N. 23° E. 11 chs. from SW cor. DLC 38

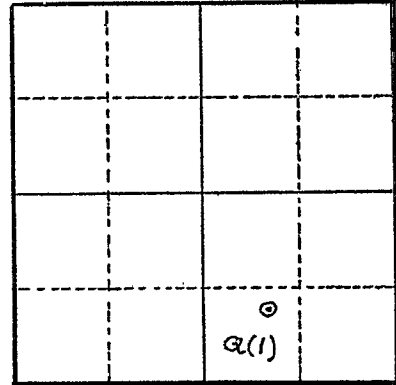

Section 11

Altitude at well 178 ft.

TYPE OF WELL: drilled Date Constructed May 1944

Depth drilled 29 ft. Depth cased 29 ft.

CASING RECORD: 6 inch

FINISH:

AQUIFERS:

WATER LEVEL: 12 ft.

PUMPING EQUIPMENT: Type Fairbanks Morse centrifugal H.P. 3
Capacity 100 G.P.M.

WELL TESTS:
Drawdown 1 ft. after 200 hours G.P.M.
Drawdown ft. after hours G.P.M.

USE OF WATER manufacture (mint still) Temp. °F. 19

SOURCE OF INFORMATION GR-648

DRILLER or DIGGER W.O. Boyer; Salem, Oregon

ADDITIONAL DATA:

Log Water Level Measurements Chemical Analysis Aquifer Test

REMARKS: