

STATE ENGINEER
Salem, Oregon

Linn
5321

Well Record


STATE WELL NO. 10/LW-11R(1)
COUNTY Linn
APPLICATION NO. GR-647

OWNER: Aden A. Chambers
MAILING ADDRESS: Rt. 2, Box 322

LOCATION OF WELL: Owner's No. 3
CITY AND STATE: Albany, Oregon

SE 1/4 SE 1/4 Sec. 11 T. 10 N. S. R. 4 W., W.M.

Bearing and distance from section or subdivision
corner N. 46° E. 15.25 chs. from SW cor. DLG 38

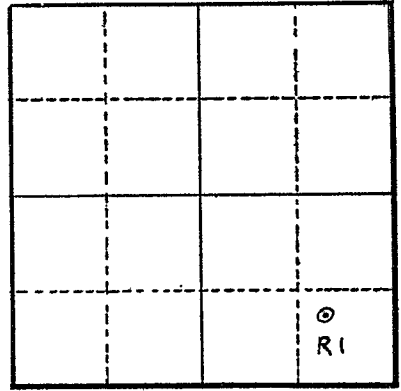

Section 11

Altitude at well 175 ft. Interpolated

TYPE OF WELL: drilled Date Constructed 1941

Depth drilled 23 ft. Depth cased 23 ft.

CASING RECORD:

FINISH:

AQUIFERS:

WATER LEVEL:

PUMPING EQUIPMENT: Type Cornell centrifugal H.P. 30
Capacity 700 G.P.M.

WELL TESTS:
Drawdown 5 ft. after 1000 hours G.P.M.
Drawdown ft. after hours G.P.M.

USE OF WATER irrigation 71.9 acres Temp. °F. 19

SOURCE OF INFORMATION GR-647

DRILLER or DIGGER Fred Wymore; Salem, Oregon

ADDITIONAL DATA:
Log Water Level Measurements Chemical Analysis Aquifer Test

REMARKS: