

STATE ENGINEER  
Salem, Oregon

Linn  
5332

# Well Record

G.R.-936

STATE WELL NO. 10/44-12G(1)

COUNTY Linn

APPLICATION NO. GR-965

OWNER: Gordon & Hazel Hofer

MAILING

ADDRESS: Rt. 2, Box 336B

LOCATION OF WELL: Owner's No. #1


CITY AND

STATE: Albany, Oregon

SW 1/4 NE 1/4 Sec. 12 T. 10 S., R. 4 W., W.M.

Bearing and distance from section or subdivision

corner N38°30'W. 57.7 ch. from SE cor. Sec. 12.

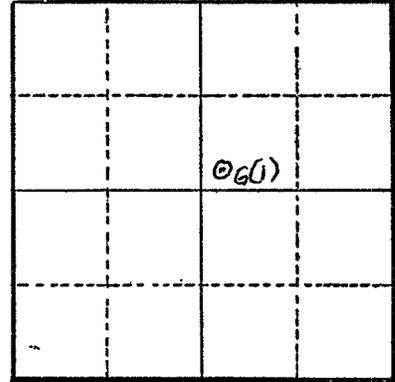

Altitude at well 185 ft.

TYPE OF WELL: Drilled Date Constructed 1952

Depth drilled 36 ft. Depth cased 36 ft.

Section 12

### CASING RECORD:

10 ft.

### FINISH:

Slot perforations from 28 to 36 ft.

### AQUIFERS:

### WATER LEVEL:

14 ft.

PUMPING EQUIPMENT: Type Pacific Centrifugal 3 inch H.P. 15

Capacity 400 G.P.M.

### WELL TESTS:

Drawdown 3 ft. after 300 hours G.P.M.

Drawdown ft. after hours G.P.M.

USE OF WATER Irrigation Temp. °F., 19

SOURCE OF INFORMATION G.R. Record

DRILLER or DIGGER Bill Hamilton Drilling Co.

### ADDITIONAL DATA:

Log Water Level Measurements Chemical Analysis Aquifer Test

### REMARKS:

Irrigation of 21.8 acres.