

STATE ENGINEER
Salem, Oregon

Linn
5334

Well Record


STATE WELL NO. 10/LW-12H(2)
COUNTY Linn
APPLICATION NO. GR-89

OWNER: Leo F. & Beryl G. Michele
MAILING ADDRESS: 1130 West 12th Ave.

LOCATION OF WELL: Owner's No. 2
CITY AND STATE: Albany, Oregon

SE 1/4 NE 1/4 Sec. 12 T. 10 S., R. 4 W., W.M.

Bearing and distance from section or subdivision
corner S. 26 1/2° W. 27.5 chs. from NE cor. Sec. 12

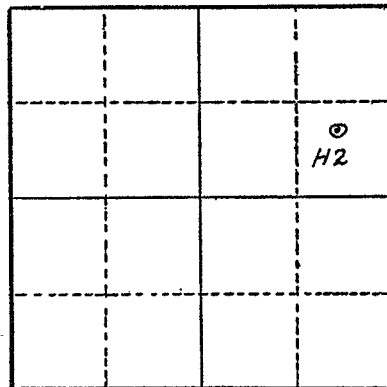

Section 12

Altitude at well 174 ft. Interpolated

TYPE OF WELL: drilled Date Constructed 6/2/47

Depth drilled 23 1/2 ft. Depth cased 23 1/2 ft.

CASING RECORD: 10 inch casing set from 0 to 23 1/2 ft.

FINISH: Staggered slots 12" x 1/4" from 14 1/2 ft. to 23 1/2 ft.

AQUIFERS: Sand & gravel from 2 to 23 1/2 ft.

WATER LEVEL: 8 ft. below land surface

PUMPING EQUIPMENT: Type 2 1/2" Allis Chalmers H.P. 15
Capacity 375 G.P.M.

WELL TESTS:
Drawdown 10 ft. after _____ hours 300 G.P.M.
Drawdown _____ ft. after _____ hours _____ G.P.M.

USE OF WATER irrigation 75.65 acres Temp. _____ °F., 19

SOURCE OF INFORMATION Reg. St. GR-89

DRILLER or DIGGER _____

ADDITIONAL DATA:
Log Water Level Measurements _____ Chemical Analysis _____ Aquifer Test _____

REMARKS:

