

STATE ENGINEER
Salem, Oregon

Linn
5335

Well Record


STATE WELL NO. 10/LW-12H(1)
COUNTY Linn
APPLICATION NO. GR-89

OWNER: Leo F. & Beryl G. Michele
MAILING ADDRESS: 1130 West 12th Avenue

LOCATION OF WELL: Owner's No. 1
CITY AND STATE: Albany, Oregon

SE 1/4 NE 1/4 Sec. 12 T. 10 S. R. 4 W., W.M.

Bearing and distance from section or subdivision
corner S. 19 1/2° W. 38.5 chs. from NE cor. Sec. 12

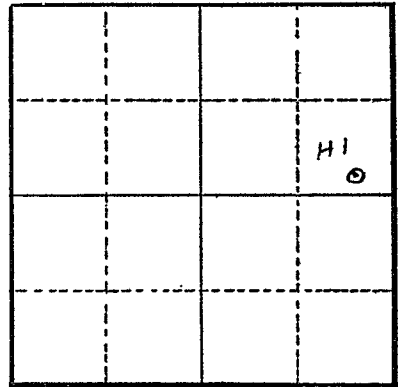

Section 12

Altitude at well 179 ft. Interpolated

TYPE OF WELL: drilled Date Constructed 6/1/47

Depth drilled 29 ft. Depth cased 29 ft.

CASING RECORD: 10 inch casing set from 0 to 29 ft.

FINISH: Staggered slots 12" x 1/4" from 20 to 29 ft.

AQUIFERS: Sand and gravel from 8 to 29 ft.

WATER LEVEL: 12 ft. below land surface

PUMPING EQUIPMENT: Type 3" Fairbanks Morse centrifugal H.P. 15
Capacity 450 G.P.M.

WELL TESTS:
Drawdown 15 ft. after _____ hours 400 G.P.M.
Drawdown _____ ft. after _____ hours _____ G.P.M.

USE OF WATER irrigation 75 acres Temp. °F. 19

SOURCE OF INFORMATION Reg. St. GR-89

DRILLER or DIGGER

ADDITIONAL DATA:
Log Water Level Measurements _____ Chemical Analysis _____ Aquifer Test _____

REMARKS:

