

STATE ENGINEER
Salem, Oregon

Linn
5336

Well Record

STATE WELL NO. 10/4W-12H(3)
COUNTY Linn
APPLICATION NO. GR-966

GR-937

OWNER: Gordon & Hazel Hoefler


MAILING ADDRESS: Rt. 1, Box 336B

LOCATION OF WELL: Owner's No. #2

CITY AND STATE: Albany, Oregon

SE ¼ NE ¼ Sec. 12 T. 10 S., R. 4 W., W.M.

Bearing and distance from section or subdivision corner N59°45'W, 40.6 ch. from the SE cor. Sec. 12

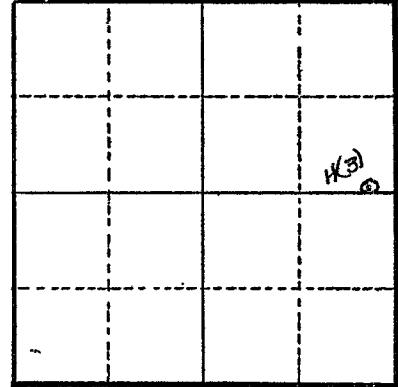

Section 12

Altitude at well 185.2 ft.

TYPE OF WELL: Drilled Date Constructed 1952

Depth drilled 36 ft. Depth cased 36 ft.

CASING RECORD:

10 inch

FINISH:

Slot perforations from 28 to 36 ft.

AQUIFERS:

WATER LEVEL:

12 ft.

PUMPING EQUIPMENT: Type Allis Chalmers 1½" Centrifugal H.P. 7½

Capacity 200 G.P.M.

WELL TESTS:

Drawdown 8 ft. after _____ hours 200 G.P.M.

Drawdown _____ ft. after _____ hours _____ G.P.M.

USE OF WATER Irrigation Temp. _____ °F., 19 _____

SOURCE OF INFORMATION G.R. Record

DRILLER or DIGGER Bill Hamilton Drilling Co.

ADDITIONAL DATA:

Log _____ Water Level Measurements _____ Chemical Analysis _____ Aquifer Test _____

REMARKS:

Irrigation of 4.3 acres.