

STATE ENGINEER
Salem, Oregon

Linn
5337

Well Record

GR-938

STATE WELL NO. 10/4W-12J(1)
COUNTY Linn
APPLICATION NO. GR-967

OWNER: Gordon & Hazel Hoefler


MAILING ADDRESS: Rt. 2, Box 336 B

LOCATION OF WELL: Owner's No. #3

CITY AND STATE: Albany, Oregon

NE 1/4 SE 1/4 Sec. 12 T. 10 S., R. 4 W., W.M.

Bearing and distance from section or subdivision corner N21°30'W. 38.5 ch. from SE cor. Sec. 12.

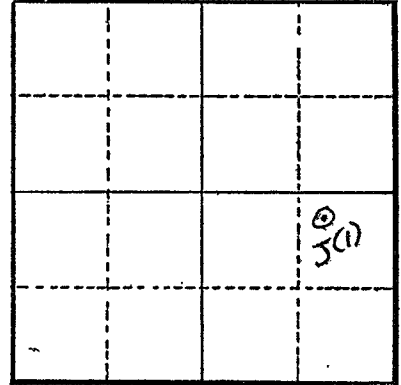

Section 12

Altitude at well 184.6 ft.

TYPE OF WELL: Drilled Date Constructed 1940

Depth drilled 28 ft. Depth cased 28 ft.

CASING RECORD:

10 in.

FINISH:

Slot perforations from 20 to 28 ft.

AQUIFERS:

WATER LEVEL:

12 ft.

PUMPING EQUIPMENT: Type Fairbanks Morse 3" Centrifugal H.P. Diesel Cat
Capacity 400 G.P.M.

WELL TESTS:

Drawdown 8 ft. after 250 hours G.P.M.
Drawdown ft. after hours G.P.M.

USE OF WATER Irrigation Temp. °F., 19

SOURCE OF INFORMATION G.R. Record

DRILLER or DIGGER W. A. Sloper

ADDITIONAL DATA:

Log Water Level Measurements Chemical Analysis Aquifer Test

REMARKS:

Irrigation of 13.7 acres.