

STATE ENGINEER
Salem, Oregon

Linn
5338

Well Record

GR-939

STATE WELL NO. 10/4W-12K(1)
COUNTY Linn
APPLICATION NO. GR-968

OWNER: Gordon & Hazel Hoefler


MAILING ADDRESS: Rt. 2, Box 336B

LOCATION OF WELL: Owner's No. #4

CITY AND STATE: Albany, Oregon

NW 1/4 SE 1/4 Sec. 12 T. 10 S., R. 4 W., W.M.

Bearing and distance from section or subdivision corner N42°45'W, 40.4 ch. from SE cor. Sec. 12

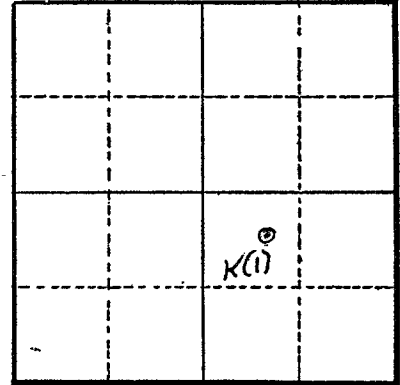

Section 12

Altitude at well 183.8 ft.

TYPE OF WELL: Drilled Date Constructed 1940

Depth drilled 28 ft. Depth cased 28 ft.

CASING RECORD:

10 inch

FINISH:

Slot perforations 22 to 28 ft.

AQUIFERS:

WATER LEVEL:

8 ft.

PUMPING EQUIPMENT: Type Rainflow 4" Centrifugal H.P. 40
Capacity 800 G.P.M.

WELL TESTS:

Drawdown 6 ft. after 800 hours G.P.M.

Drawdown ft. after hours G.P.M.

USE OF WATER Irrigation Temp. °F., 19

SOURCE OF INFORMATION G.E. Record

DRILLER or DIGGER W.A. Sloper

ADDITIONAL DATA:

Log Water Level Measurements Chemical Analysis Aquifer Test

REMARKS:

Irrigation of 76.2 acres.