

STATE ENGINEER
Salem, Oregon

Linn
5339

Well Record

STATE WELL NO. 10/4W-12K(2)
COUNTY Linn
APPLICATION NO. GE-969

GR-940

OWNER: Gordon & Hazel Hoefler


MAILING ADDRESS: Rt. 2, Box 336B

LOCATION OF WELL: Owner's No. #5

CITY AND STATE: Albany, Oregon

NW 1/4 SE 1/4 Sec. 12 T. 10 S., R. 4 W., W.M.

Bearing and distance from section or subdivision
corner N46°W. 51 ch. from SE cor. of Sec. 12.

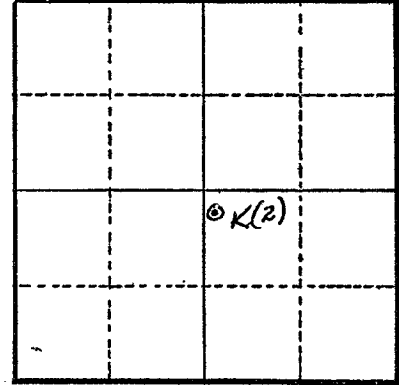

Section 12

Altitude at well 184.5 ft.

TYPE OF WELL: Drilled Date Constructed 1947

Depth drilled 30 ft. Depth cased 30 ft.

CASING RECORD:

10 inch

FINISH:

Slot perforations from 24 to 30 ft.

AQUIFERS:

WATER LEVEL:

10 ft.

PUMPING EQUIPMENT: Type Fairbanks Morse 3" H.P. _____
Capacity 300 G.P.M.

WELL TESTS:

Drawdown 10 ft. after _____ hours 300 G.P.M.

Drawdown _____ ft. after _____ hours _____ G.P.M.

USE OF WATER Irrigation Temp. _____ °F., 19 _____

SOURCE OF INFORMATION G.R. Record

DRILLER or DIGGER W. A. Sloper

ADDITIONAL DATA:

Log _____ Water Level Measurements _____ Chemical Analysis _____ Aquifer Test _____

REMARKS:

Irrigation of 21.8 acres.