

STATE ENGINEER
Salem, Oregon

Linn
5340

Well Record


STATE WELL NO. 10/14W-12L
COUNTY Linn
APPLICATION NO. GR-3865

OWNER: Marion G. Hoefler & Carol Hoefler MAILING ADDRESS: Route 2, Box 333

LOCATION OF WELL: Owner's No. CITY AND STATE: Albany, Oregon

NE 1/4 SW 1/4 Sec. 12 T. 10 S., R. 4 W., W.M.

Bearing and distance from section or subdivision
corner S. 89° 25' E. 35.2 chs. from NW Cor. of SW 1/4
Sec. 12

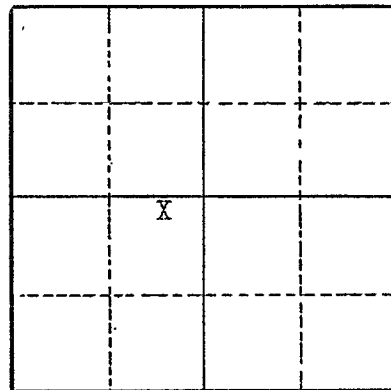

Section 12

Altitude at well

TYPE OF WELL: Drilled Date Constructed Oct. 1948

Depth drilled 35 feet Depth cased 35 feet

CASING RECORD:

10 inch steel casing set to 35 feet

FINISH:

Slot perforations no pattern from 26 to 33 ft.
Reclaimed pipe damaged by dynamite in previous location.

AQUIFERS:

WATER LEVEL:

20 feet below surface

PUMPING EQUIPMENT: Type Pacific 2" centrifugal H.P. 10
Capacity 225 G.P.M.

WELL TESTS:

Drawdown 15 ft. after 225 hours G.P.M.
Drawdown ft. after hours G.P.M.

USE OF WATER Irrigation Temp. °F., 19

SOURCE OF INFORMATION Well Registration Statement Cert. # GR-3518

DRILLER or DIGGER Bill Hamilton

ADDITIONAL DATA:

Log Water Level Measurements Chemical Analysis Aquifer Test

REMARKS:

Log	Thickness	Depth to Bottom
Soil	10	25
Medium gravel, water bearing	25	0
Blue clay		