

STATE ENGINEER
Salem, Oregon

Linn
5342


Well Record

STATE WELL NO. 10/4W-12M
COUNTY Linn
APPLICATION NO. GR-3864

OWNER: Marion C. Hoefler & Carol Hoefler MAILING ADDRESS: Route 2, Box 333
CITY AND STATE: Albany, Oregon

LOCATION OF WELL: Owner's No. _____
NW 1/4 SW 1/4 Sec. 12 T. 10 S., R. 4 W., W.M.

Bearing and distance from section or subdivision
corner S. 71° 30' E. 20.9 chs. from NW Cor. of
SW 1/4 Sec. 12

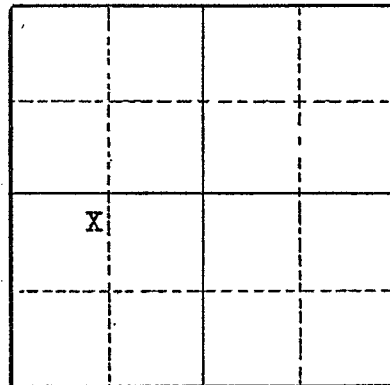

Section 12

Altitude at well _____

TYPE OF WELL: Drilled Date Constructed 8/15/51

Depth drilled 20 ft. Depth cased 20 ft.

CASING RECORD:

12 inch steel casing set to 20 feet

FINISH:

slot perforations cut by torch from 12 to 20 feet
Number about 80 Size $\frac{1}{2}$ " x 12"

AQUIFERS:

WATER LEVEL:

7 feet below surface

PUMPING EQUIPMENT: Type Pacific 3" centrifugal H.P. 20
Capacity 450 G.P.M.

WELL TESTS:

Drawdown _____ ft. after _____ hours _____ G.P.M.
Drawdown _____ ft. after _____ hours _____ G.P.M.

USE OF WATER Irrigation Temp. _____ °F., 19 _____

SOURCE OF INFORMATION Well Registration Statement Cert. # GR-3517

DRILLER or DIGGER Bill Hamilton

ADDITIONAL DATA:

Log Water Level Measurements _____ Chemical Analysis _____ Aquifer Test _____

REMARKS:

| | | | |
|------------------------------|--|-----------|-----------------|
| Log: | | Thickness | Depth to Bottom |
| Heavy soil | | 6 | 14 |
| Mixed gravel sand to 6" size | | 14 | 0 |
| Water bearing | | | |
| Blue clay no water | | ? | |