

STATE ENGINEER
Salem, Oregon

Linn
5343

Well Record

STATE WELL NO. 10/4W-12P
COUNTY Linn
APPLICATION NO. GR-4250

OWNER: Raymond K. Baker


MAILING ADDRESS: Rt. 2, Box 318

LOCATION OF WELL: Owner's No.

CITY AND STATE: Albany, Oregon

SE 1/4 SW 1/4 Sec. 12 T. 10 S., R. 4 W., W.M.

Bearing and distance from section or subdivision corner N 83° 30' W 59.32 chains from SE corner S 12, T10S, R 4W

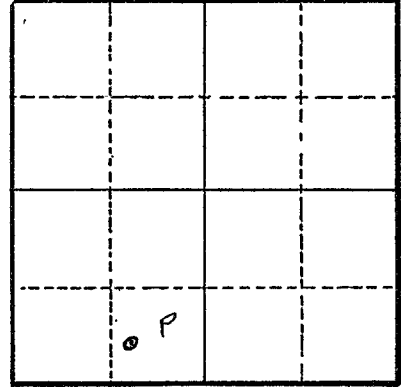

Section 12

Altitude at well

TYPE OF WELL: Drilled Date Constructed 1953

Depth drilled 38' Depth cased 38'

CASING RECORD:

12-inch

FINISH:

Slot perforations 30' to 38'

AQUIFERS:

WATER LEVEL:

24'

PUMPING EQUIPMENT: Type Fairbanks Morse H.P. 20

Capacity 440 G.P.M.

WELL TESTS:

Drawdown ft. after hours G.P.M.
Drawdown ft. after hours G.P.M.

USE OF WATER Irrigation Temp. °F., 19

SOURCE OF INFORMATION GR-3836

DRILLER or DIGGER Bill Hamilton

ADDITIONAL DATA:

Log NA Water Level Measurements Chemical Analysis Aquifer Test

REMARKS: