

STATE ENGINEER
Salem, Oregon

Linn
5345

Well Record

STATE WELL NO. 10/4W-12Q
COUNTY Linn
APPLICATION NO. GR-3708

OWNER: Raymond K. Baker


MAILING ADDRESS: Rt 2, Box 318

LOCATION OF WELL: Owner's No.

CITY AND STATE: Albany, Oregon

SW 1/4 SE 1/4 Sec. 12 T. 10 N. S., R. 4 E. W.M.

Bearing and distance from section or subdivision corner N 58° 30' W 35.3 chains from SE corner S 12, T10S, R 4W

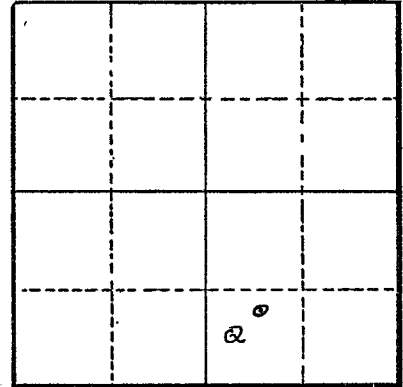

Section 12

Altitude at well

TYPE OF WELL: Drilled Date Constructed 1954

Depth drilled 36' Depth cased 36'

CASING RECORD:

12-inch

FINISH:

Slot perforations 26' to 36'

AQUIFERS:

WATER LEVEL:

18'

PUMPING EQUIPMENT: Type Jacuzzi H.P. 40
Capacity 800 G.P.M.

WELL TESTS:

Drawdown ft. after hours G.P.M.
Drawdown ft. after hours G.P.M.

USE OF WATER Irrigation Temp. °F., 19

SOURCE OF INFORMATION GR-3834

DRILLER or DIGGER Bill Hamilton

ADDITIONAL DATA:

Log NA Water Level Measurements Chemical Analysis Aquifer Test

REMARKS: