

STATE ENGINEER  
Salem, Oregon

Linn  
5346

# Well Record


STATE WELL NO. 10/4W-12Q  
COUNTY Linn  
APPLICATION NO. GR-3786

OWNER: Raymond K. Baker  
MAILING ADDRESS: Route 2, Box 318

LOCATION OF WELL: Owner's No. \_\_\_\_\_  
CITY AND STATE: Albany, Oregon

SW 1/4 SE 1/4 Sec. 12 T. 10 N. R. 4 W., W.M.

Bearing and distance from section or subdivision  
corner N. 65° 10' W. 43.5 ch. from SE Cor. Sec. 12

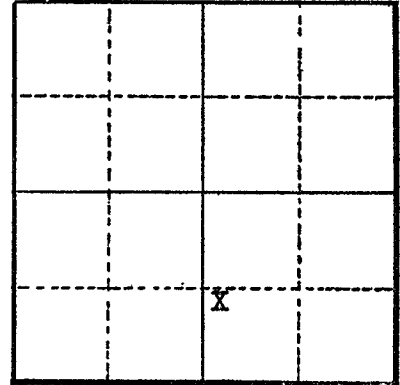

Section 12

Altitude at well \_\_\_\_\_

TYPE OF WELL: Drilled Date Constructed 1945

Depth drilled 32 feet Depth cased 32 feet

### CASING RECORD:

12 inch steel casing set 7 to 32 feet

### FINISH:

Slot perforations from 20 to 32 feet

### AQUIFERS:

### WATER LEVEL:

18 feet below surface

PUMPING EQUIPMENT: Type Fairbanks Morse centrifugal H.P. 20  
Capacity 440 G.P.M.

### WELL TESTS:

Drawdown \_\_\_\_\_ ft. after \_\_\_\_\_ hours \_\_\_\_\_ G.P.M.

Drawdown \_\_\_\_\_ ft. after \_\_\_\_\_ hours \_\_\_\_\_ G.P.M.

USE OF WATER Irrigation Temp. \_\_\_\_\_ °F., 19

SOURCE OF INFORMATION Well Registration Statement

DRILLER or DIGGER Bill Hamilton Drilling Co.

### ADDITIONAL DATA:

Log \_\_\_\_\_ Water Level Measurements \_\_\_\_\_ Chemical Analysis \_\_\_\_\_ Aquifer Test \_\_\_\_\_

### REMARKS:

3447