

STATE ENGINEER
Salem, Oregon

Linn
5351

Well Record

STATE WELL NO. 10/4W-13C
COUNTY Linn
APPLICATION NO. GR-3709

OWNER: Raymond K. Baker


MAILING ADDRESS: Rt. 2, Box 318

LOCATION OF WELL: Owner's No.

CITY AND STATE: Albany, Oregon

NE 1/4 NW 1/4 Sec. 13 T. 10 N. S., R. 4 W., W.M.

Bearing and distance from section or subdivision corner S 85° 20' W, 49.9 chains from NE corner S 13, T 10S, R 4W

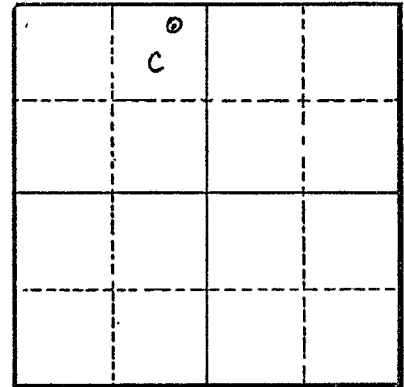

Section 13

Altitude at well

TYPE OF WELL: Drilled Date Constructed 1954

Depth drilled 38' Depth cased 38'

CASING RECORD:

12-inch

FINISH:

slot perforations 30' to 38'

AQUIFERS:

WATER LEVEL: 30'

PUMPING EQUIPMENT: Type Jacuzzi Turbine H.P. 5
Capacity 200 G.P.M.

WELL TESTS:

Drawdown ft. after hours G.P.M.
Drawdown ft. after hours G.P.M.

USE OF WATER Irrigation Temp. °F., 19

SOURCE OF INFORMATION GR-3835

DRILLER or DIGGER Bill Hamilton

ADDITIONAL DATA:

Log NA Water Level Measurements Chemical Analysis Aquifer Test

REMARKS: