

STATE ENGINEER
Salem, Oregon

LINN
4487


Well Record

STATE WELL NO. 10/3W-4K(1)
COUNTY Linn
APPLICATION NO. GR-325

OWNER: Charles & Doris Grizzel
MAILING ADDRESS: RT. 2, Box 383
CITY AND STATE: Albany, Oregon

LOCATION OF WELL: Owner's No. 2 & 3
N. W. 1/4 SE 1/4 Sec. 4 T. 10 S., R. 3 W., W.M.

Bearing and distance from section or subdivision
corner #2 - S. 58° W. 24.5 chs. from NE cor. SE 1/4 Sec. 4
#3 - S. 64° W. 28.8 chs. from NE cor. SE 1/4 Sec. 4

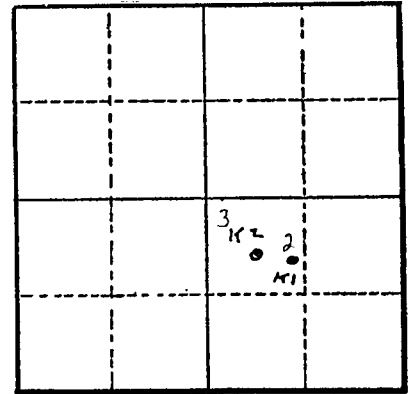

Section 4

Altitude at well 200 ft. Interpolated
TYPE OF WELL: #2 drilled #3 driven Date Constructed #3 8/16/48
Depth drilled 24 ft. Depth cased 24 ft.

CASING RECORD: #2 - 8 inch casing set from 0 to 24 ft.
#3 - 8 inch casing set from 0 to 24 ft.

FINISH: #2 slit perforations set from 12 to 24 ft.
#3 slit perforations set from 14 to 24 ft.

AQUIFERS: unknown

WATER LEVEL:

PUMPING EQUIPMENT: Type #2 = Allis Chalmers 3" centrifugal #3 = Allis Chalmers 2" centrifugal H.P. 15
Capacity #2) 420 #3) 166 G.P.M.

WELL TESTS:
Drawdown 1 ft. after hours pumping 420 #2 G.F.
Drawdown ft. after hours pumping 160 #3 G.F.

USE OF WATER irrigation 45.5 acres Temp. °F., 19.

SOURCE OF INFORMATION Reg. St. GR-325
DRILLER or DIGGER Bill Hamilton Well Drilling Co.; Albany, Oregon

ADDITIONAL DATA:
Log Water Level Measurements Chemical Analysis Aquifer Test

REMARKS: