

STATE ENGINEER
Salem, Oregon

Linn
5353

Well Record


STATE WELL NO. 10/4W-13D
COUNTY LINN
APPLICATION NO. GR-2397

OWNER: Charles W. and Patricia M. Chambers MAILING ADDRESS: Rt. 2, Box 329

LOCATION OF WELL: Owner's No. _____ CITY AND STATE: Albany, Oregon

NW 1/4 NW 1/4 Sec. 13 T. 10 S, R. 4 W., W.M.

Bearing and distance from section or subdivision corner S. 77° 45' E. 810 chains

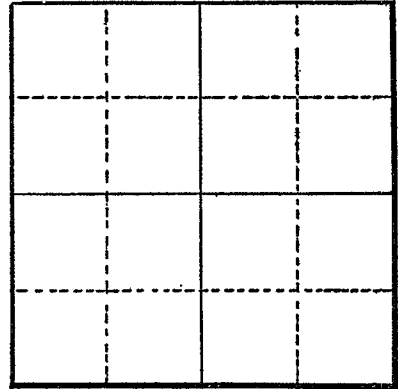

Section _____

Altitude at well _____

TYPE OF WELL: Drilled Date Constructed 1954

Depth drilled 42 Depth cased 42

CASING RECORD:

10-inch

FINISH:

Slot perforations from 32 to 42

AQUIFERS:

WATER LEVEL:

18-feet

PUMPING EQUIPMENT: Type Fairbanks Morse 2 1/2" Centrifugal H.P. 10
Capacity 225 G.P.M.

WELL TESTS:

Drawdown _____ ft. after _____ hours _____ G.P.M.
Drawdown _____ ft. after _____ hours _____ G.P.M.

USE OF WATER Irrigation Temp. _____ °F. _____, 19____

SOURCE OF INFORMATION GR-2278

DRILLER or DIGGER Nicholas Klaus, Route 4, Albany, Oregon

ADDITIONAL DATA:

Log _____ Water Level Measurements _____ Chemical Analysis _____ Aquifer Test _____

REMARKS: