

STATE ENGINEER
Salem, Oregon

Linn
5357

Well Record


STATE WELL NO. 10/LW-13G(1)
COUNTY Linn
APPLICATION NO. GR-327

OWNER: Marvin W. & Helen E. Fletcher
MAILING ADDRESS: Rt. 2, Box 315

LOCATION OF WELL: Owner's No. 1
CITY AND STATE: Albany, Oregon

SW 1/4 NE 1/4 Sec. 13 T. 10 N. S., R. 4 E., W.M.

Bearing and distance from section or subdivision corner 40 chs. W. from NE cor. SE 1/4 Sec. 13

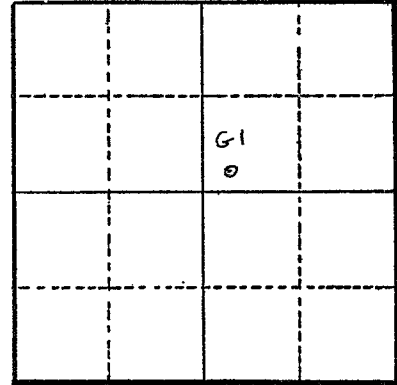

Altitude at well 185 ft. Interpolated

TYPE OF WELL: drilled Date Constructed 10/1/51

Depth drilled 32 ft. Depth cased 32 ft.

Section 13

CASING RECORD: 8 inch steel casing set from 0 to 32 ft.

FINISH: Slit perforations set from 17 to 32 ft.

AQUIFERS: unknown

WATER LEVEL: 12 ft. below land surface

PUMPING EQUIPMENT: Type Fairbanks Morse 2" centrifugal H.P. 10
Capacity 200 G.P.M.

WELL TESTS:
Drawdown 14 ft. after _____ hours pumping 170 G.P.M.
Drawdown _____ ft. after _____ hours _____ G.P.M.

USE OF WATER irrigation 15.8 acres Temp. _____ °F., 19

SOURCE OF INFORMATION Reg. St. GR-327

DRILLER or DIGGER Nicholas Klaus; Albany, Oregon

ADDITIONAL DATA:
Log _____ Water Level Measurements _____ Chemical Analysis _____ Aquifer Test _____

REMARKS: