

STATE ENGINEER  
Salem, Oregon

Linn  
5358

# Well Record


STATE WELL NO. 10/4W-13G  
COUNTY LINN  
APPLICATION NO. GR-2999

OWNER: P. L. Turnidge MAILING ADDRESS: Rt. 2, Box 310

LOCATION OF WELL: Owner's No. #3 CITY AND STATE: Albany, Oregon

SW 1/4 NE 1/4 Sec. 13 T. 10 S., R. 4 W., W.M.

Bearing and distance from section or subdivision corner N. 57° E. 16.5 chains

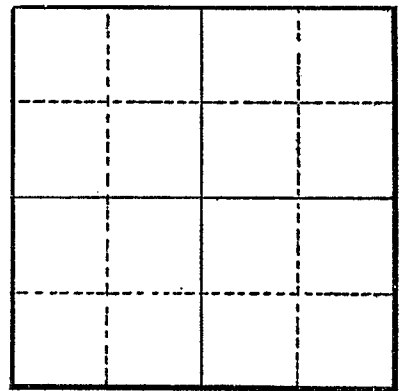

Section \_\_\_\_\_

Altitude at well \_\_\_\_\_

TYPE OF WELL: drilled Date Constructed 1951

Depth drilled 34 Depth cased 34

CASING RECORD:

10-inch

FINISH:

Slot perforations from 24 to 34

AQUIFERS:

Soil, sand and gravel

WATER LEVEL:

12-feet

PUMPING EQUIPMENT: Type Pacific Centrifugal H.P. 10  
Capacity 300 G.P.M.

WELL TESTS:

Drawdown 6 ft. after \_\_\_\_\_ hours Pumping 300 G.P.M.  
Drawdown \_\_\_\_\_ ft. after \_\_\_\_\_ hours \_\_\_\_\_ G.P.M.

USE OF WATER Irrigation Temp. \_\_\_\_\_ °F., 19

SOURCE OF INFORMATION GR-2808

DRILLER or DIGGER Bill Hamilton Drilling Co., Albany, Oregon

ADDITIONAL DATA:

Log  Water Level Measurements \_\_\_\_\_ Chemical Analysis \_\_\_\_\_ Aquifer Test \_\_\_\_\_

REMARKS:

Soil 15 15  
Sand and Gravel 19 34