

~~LINN~~
~~10502~~

OWNER: Doy Gatlin


MAILING ADDRESS: P.O. Box 206

LOCATION OF WELL: Owner's No.

CITY AND STATE: Tangent, Oregon

NW 1/4 SW 1/4 Sec. 7 T. 12 N. S., R. 3 E. W., W.M.

Bearing and distance from section or subdivision corner S. 66° 30' E. 1420' from NW corner of SW 1/4

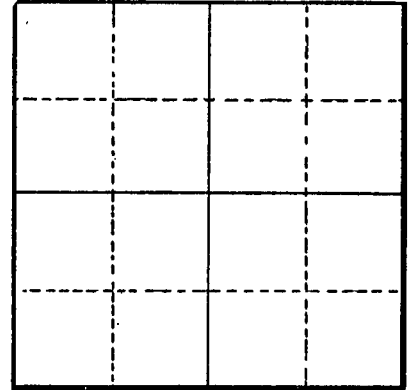

Section

Altitude at well

TYPE OF WELL: Drilled Date Constructed 1951

Depth drilled 35 Depth cased

CASING RECORD:

8-inch

FINISH:

AQUIFERS:

WATER LEVEL:

15-feet

PUMPING EQUIPMENT: Type Gould Centrifugal H.P. 3
Capacity 75 G.P.M.

WELL TESTS:

Drawdown ft. after hours G.P.M.
Drawdown ft. after hours G.P.M.

USE OF WATER Irrigation Temp. °F., 19

SOURCE OF INFORMATION GR-2189

DRILLER or DIGGER

ADDITIONAL DATA:

Log Water Level Measurements Chemical Analysis Aquifer Test

REMARKS: