

~~LINN~~
~~10540~~

OWNER: Jenks Hatcher

MAILING ADDRESS:

LOCATION OF WELL: Owner's No.


CITY AND STATE:

Tangent, Oregon

SE 1/4 NW 1/4 Sec. 18 T. 12 S., R. 3 W., W.M.

Bearing and distance from section or subdivision

corner 1914' S. & 2574' E. of NW Cor. Sec. 18

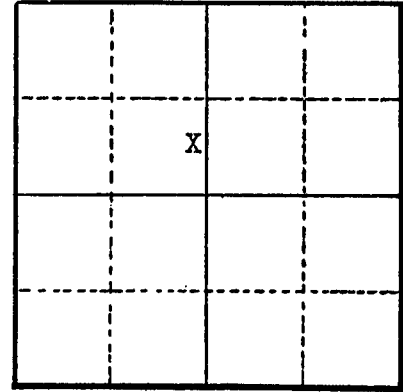

Section 18

Altitude at well

TYPE OF WELL: Drilled Date Constructed 1950

Depth drilled 95 feet Depth cased 95 feet

CASING RECORD:

6 inch steel casing set to 95 feet

FINISH:

Slot perforations from 65 to 95 feet

AQUIFERS:

WATER LEVEL:

24 feet below surface

PUMPING EQUIPMENT: Type Demming centrifugal H.P. 5

Capacity 100 G.P.M.

WELL TESTS:

Drawdown ft. after hours G.P.M.

Drawdown ft. after hours G.P.M.

USE OF WATER Irrigation Temp. °F. 19

SOURCE OF INFORMATION Well Registration Statement

DRILLER or DIGGER W. A. Slate

ADDITIONAL DATA:

Log Water Level Measurements Chemical Analysis Aquifer Test

REMARKS:

3436